

NOTES / LEGEND

- EXISTING SUB-SOIL DRAIN
- EXISTING STORMWATER MAIN
- EXISTING SEWER MAIN
- EXISTING EFF CONNECTION
- EXISTING WATER MAIN
- EXISTING VALVE
- EXISTING FIRE HYDRANT
- EXISTING TREATED EFFLUENT
- EXISTING TREATED EFFLUENT VALVE
- EXISTING IRRIGATION DUCT
- EXISTING ELECTRICAL DUCT
- EXISTING RHN-NODE 400 BOX
- EXISTING RHN-NODE 600 BOX
- EXISTING TELECOMMUNICATION CONNECTION
- EXISTING TELECOMMUNICATION DUCT

APPROVED BY COUNCIL / CLIENT

CITY ENGINEER / CLIENT	REG. NO.	DATE
AMENDMENTS CODE		
A.B.C. / BEFORE TENDER	H. BY CLIENT	
T. / TENDER DRAWING	B. BY ARCHITECT	
Q.12.3. / AFTER TENDER	C. BY MECHANICAL/ELECTRICAL	
Z. / AS BUILT	D. BY BIM	
	E. BY OTHER	

DATE	INITIAL	No. CODE	REVISION DESCRIPTION
13/09/2023	PN	Z0D	FOR AS-BUILTS

MILNERTON ESTATES
PROPERTY DEVELOPERS

bvi 50 YEAR CELEBRATION EST 1967-2017
• ENGINEERING • PROCUREMENT • MANAGEMENT

CLIENT

PROVINCE OFFICE

Gauteng	Tshwane	(011) 860-1111
Free State	Pretoria	(015) 291-0400
	Bloemfontein	(051) 440-0101
	Polokwane	(051) 252-0400
Northern Cape	Sunyani	(054) 337-0000
	Sengweni	(023) 713-3814
KwaZulu Natal	Durban	(031) 284-0000
	Empangeni	(035) 770-0112
Eastern Cape	Port Elizabeth	(041) 275-4543
	East London	(043) 725-3888
Western Cape	Cape Town	(021) 557-7000

Visit or contact us online at www.bvi.co.za

PROJECT


THE CONSTRUCTION OF ROADS AND CIVIL SERVICES FOR SANDOWN PHASE 6A

DRAWING TITLE

GENERAL SERVICES LAYOUT

APPROVED BY BVI

ENGINEER/TECHNOLOGIST	REG. NO.	DATE
SCALE: 1:500 @A1	DRAWN: PN	
DESIGNED: CDP	CHECKED: DA	
PLAN NUMBER: 34700.03-101-01	REVISION NO.: Z0	DATE SAVED: September 14, 2023

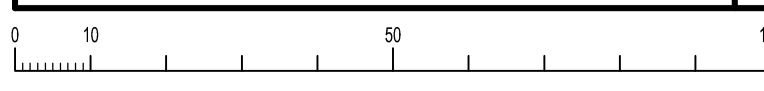

34700.03-100.DWG